



INDEX OF SHEETS

Sheet
Number

- 1 Title and Location Map
- 2-3 Typical Cross Sections
- 4-5 Standard Plans List
- 6-11 Layout
- 12-13 Construction Details
- 14-17 Contour Grading
- 18-25 Drainage Plans
- 26-29 Drainage Profiles
- 30-38 Drainage Details
- 39-41 Drainage Quantities
- 42-45 Traffic Handling
- 46 Construction Area Signs
- 47-49 Summary of Quantities
- 50 Retaining Wall
- 51-52 Irrigation Plans
- 53-61 Electrical Plans

PROJECT PLANS FOR CONSTRUCTION ON
AND ADJACENT TO
STATE HIGHWAY
IN LOS ANGELES COUNTY
AT VARIOUS LOCATIONS

To be supplemented by Standard Plans dated July, 1997

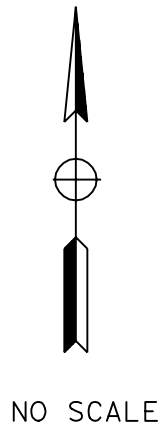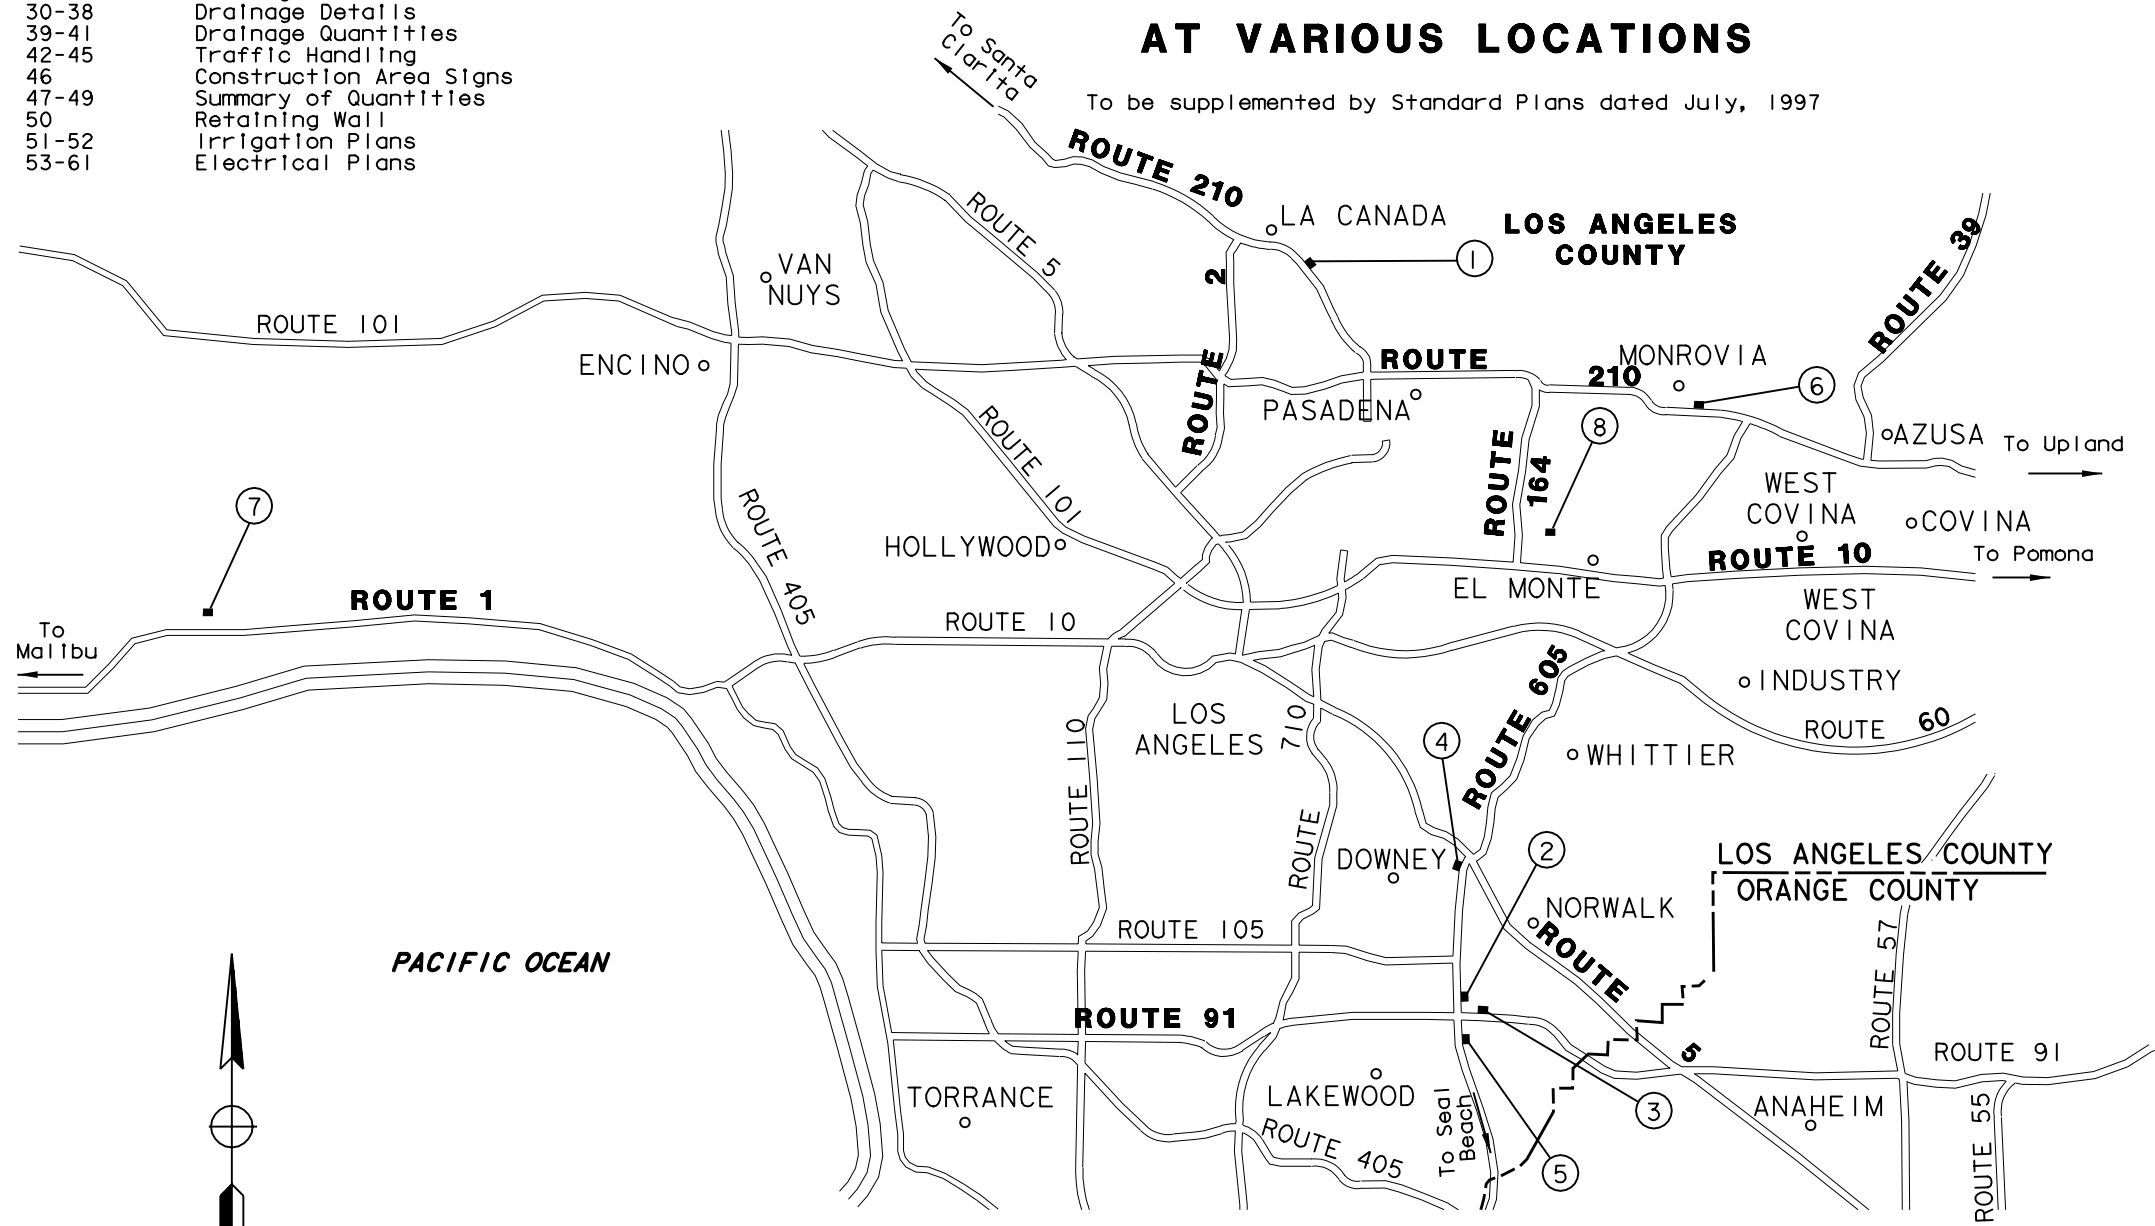

LOCATION OF CONSTRUCTION

LOC	ROUTE	KP	PM	DESCRIPTION
①	210	36.19	22.49	ALTADENA MAINTENANCE STATION
②	605	8.18	5.08	(E) SR-91/(N) I-605 SEPARATION
③	91	27.46	17.06	(W) SR-91/CERRITOS MAINTENANCE STATION
④	5	11.18	6.95	(S) I-5/(S) I-605 SEPARATION
⑤	605	3.18	1.98	(N) I-605/DEL AMO INTERCHANGE
⑥	210	55.91	34.74	FOOTHILL MAINTENANCE STATION
⑦	1	71.00	44.12	LAS FLORES MAINTENANCE STATION
⑧	164	10.69	6.64	ROSEMEAD MAINTENANCE STATION


The Contractor shall possess the Class (or Classes) of license as specified in the "Notice to Contractors".

DIST	COUNTY	ROUTE	KILOMETER POST TOTAL PROJECT	SHEET NO	TOTAL SHEETS
07	LA	1, 5, 91, 164, 210, 605	VAR	1	61



AS-BUILT
12 / 15 / 99

Harold T. Glaser 6/30/98
Project Engineer Date
Registered Civil Engineer

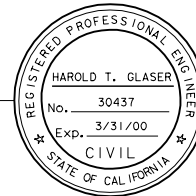

Plans Approval Date

MONTGOMERY WATSON - CHAUDHARY
750 B STREET SUITE 1610
SAN DIEGO CA 92101-8131

Contract No.

GENERAL ROAD WORK

MISCELLANEOUS

- A10A Abbreviations
- A10B Symbols
- A20A Pavement Markers and Traffic Lines, Typical Details
- A20B Pavement Markers and Traffic Lines, Typical Details
- A20C Pavement Markers and Traffic Lines, Typical Details
- A20D Pavement Markers and Traffic Lines, Typical Details
- A24A Pavement Markings- Arrows
- A24B Pavement Markings- Arrows
- A24C Pavement Markings- Symbols and Numerals
- A24D Pavement Markings- Words
- A24E Pavement Markings- Words and Crosswalks
- A35A Portland Cement Concrete Paving Details
- A40 Rumble Strip Details
- A62A Excavation and Backfill- Miscellaneous Details
- A62B Limits of Payment for Excavation and Backfill Bridge- Surcharge and Wall
- A62C Limits of Payment for Excavation and Backfill- Bridge
- A62D Excavation and Backfill- Concrete Pipe Culverts
- A62E Excavation and Backfill- Cast-In-Place Reinforced Concrete Box and Arch Culverts
- A62F Excavation and Backfill- Metal and Plastic Culverts
- A73A Object Markers
- A73B Markers
- A73C Delineators, Channelizers and Barricades
- A74 Survey Monuments
- A75A Concrete Barrier Type 50
- A75B Concrete Barrier Type 50E
- A75D Concrete Headlight Glare Screen
- RSP A76A CONCRETE BARRIER TYPE 60
- A76B Concrete Barrier Type 60
- A76C Concrete Barrier Type 60E
- A76D Concrete Barrier Type 60G
- A76E Concrete Barrier Type 60G
- A76F Concrete Barrier Type 60GE
- RSP A76G CONCRETE BARRIER TYPE 60S
- A76H Concrete Barrier Type 60S
- A76I Concrete Barrier Type 60SE
- A77A Metal Beam Guard Railing
- A77B Metal Beam Guard Railing- Standard Hardware
- RSP A77C METAL BEAM GUARD RAILING - POST AND BLOCKS
- A77D Guard Railing Flares
- A77E Guard Railing Flares
- A77F Metal Beam Guard Railing- Miscellaneous Details
- A77G Guard Railing End Anchors (Breakaway)
- A77GA Anchor Assembly (Breakaway, Type M)-Hardware and Post Details
- A77H Guard Railing End Anchors- Breakaway Hardware
- A77I Barrier and Guard Railing End Anchors
- A77J Guard Railing Connections to Bridge Railings, Retaining Walls and Abutments
- A77K Guard Railing Connections to Bridge Sidewalks and Curbs
- A78A Thrie Beam Barrier
- A78B Thrie Beam Barrier
- A78C Thrie Beam Barrier- Standard Hardware
- A78D Thrie Beam Barrier- Miscellaneous Details
- A78E Thrie Beam Barrier- End Anchors
- A78F Thrie Beam Barrier Connections to Bridge Railing
- A78G Thrie Beam Barrier Connections to Bridge Curbs, Retaining Walls and Abutments
- A78H Thrie Beam Barrier Connections to Concrete Barrier Type 50
- A78I Thrie Beam Barrier Connections to Concrete Barrier Type 60
- A81 Crash Cushion, Sand Filled
- A83 Portable Scale Pad and Approach Slab Details
- A85 Chain Link Fence
- A86 Barbed Wire and Wire Mesh Fences
- A87 Curbs, Dikes and Driveways
- A88 Curb Ramp Details
- A90 Accessible Parking

CRIB WALLS

- C7A Reinforced Concrete Crib Wall- Battered Wall- Types A,B and C
- C7B Reinforced Concrete Crib Wall- Battered Wall- Types D,E and F
- C7C Reinforced Concrete Crib Wall- Vertical Wall- Types A,B and C
- C7D Reinforced Concrete Crib Wall- Vertical Wall- Types D,E and F

- RSP C7E REINFORCED CONCRETE CRIB WALL- TYPES A,B,C,D,E AND F-HEADER AND STRECHER DETAILS
- RSP C7F DESIGN DATA FOR REINFORCED CONCRETE CRIB WALL FOUNDATION PRESSURE- BATTERED WALL
- RSP C7G REINFORCED CONCRETE CRIB WALL FOUNDATION PRESSURE- VERTICAL WALL
- C8A Steel Crib Wall- Construction Details
- C8B Steel Crib Wall- Design Data
- RSP C8C STEEL CRIB WALL- DESIGN DATA
- C9A Timber Crib Wall- Types A,B,C and D
- RSP C9B TIMBER CRIB WALL- TYPES A,B,C AND D-DESIGN DATA

DRAINAGE

- D72 Drainage Inlets
- D73 Drainage Inlets
- D74A Drainage Inlets
- D74B Drainage Inlets
- D74C Drainage Inlet Details
- D75 IS DELETED AND REPLACED WITH NSP D75A, NSP D75B AND NSP D75C)
- RSP D77A Grate Details
- D77B Bicycle Proof Grate Details
- D77C Alternative Hinged Cover for Type OL and OS Inlets and Trash Rack for Type OCP Inlet
- D78 Gutter Depressions
- D79 Precast Reinforced Concrete Pipe- Direct Design Method
- D80 Cast-In-Place Reinforced Concrete Single Box Culvert
- D81 Cast-In-Place Reinforced Concrete Double Box Culvert
- D82 Cast-In-Place Reinforced Concrete Box Culvert Miscellaneous Details
- D84 Box Culvert Wingwalls- Types A,B and C
- RSP D85 BOX CULVERT WINGWALLS- TYPES D AND E
- D86A Box Culvert Warped Wingwalls
- D86B Pipe Culvert Headwalls, Endwalls and Warped Wingwalls
- D86C Arch Culvert Headwalls, Endwalls and Warped Wingwalls
- D87A Overside Drains
- D87B Overside Drains
- D87C Underdrains
- D88 Construction Loads on Culverts
- D88A Strut Details for Structural Steel Plate Pipes, Arches, and Vehicular Undercrossings
- D89 Pipe Headwalls
- D90 Pipe Culvert Headwalls, Endwalls and Wingwalls-Types A,B and C
- D93A Pipe Riser Connections
- D93B Drainage Inlet Riser Connections
- D93C Pipe Riser with Debris Rack Cage
- D94A Metal and Plastic Flared End Sections
- D94B Concrete Flared End Sections
- D95 Concrete Arch Culverts
- D97A Corrugated Metal Pipe Coupling Details No. 1- Annular Coupling Band Bar and Strap and Angle Connectors
- D97B Corrugated Metal Pipe Coupling Details No. 2- Hat Band Coupler and Flange Details
- D97C Corrugated Metal Pipe Coupling Details No. 3- Helical and Universal Couplers
- D97D Corrugated Metal Pipe Coupling Details No. 4- Hugger Coupling Bands
- D97E Corrugated Metal Pipe Coupling Details No. 5- Standard Joint
- D97F Corrugated Metal Pipe Coupling Details No. 6- Positive Joint
- D97G Corrugated Metal Pipe Coupling Details No. 7- Positive Joints and Downdrains
- D97H Reinforced Concrete Pipe or Non-Reinforced Concrete Pipe Standard and Positive Joints
- D98A Slotted Corrugated Steel Pipe Drain Details
- D98B Slotted Corrugated Steel Pipe Drain Details
- D99A Structural Section Drainage System Details
- D99B Edge Drain Outlet and Vent Details
- D99C Edge Drain Cleanout and Vent Details
- D99D Cross Drain Interceptor Details

HIGHWAY PLANTING

- H1 Planting and Irrigation- Abbreviations
- RSP H2 PLANTING AND IRRIGATION- SYMBOLS
- H3 Planting and Irrigation- Details
- H4 Planting and Irrigation- Details
- H5 Planting and Irrigation- Details
- H6 Planting and Irrigation- Details
- H7 Planting and Irrigation- Details



DIST.	COUNTY	ROUTE	KILOMETER POST TOTAL PROJECT	SHEET NO.	TOTAL SHEETS
7	LA	1,5,91,164 210,605	VAR	4	61

The State of California or its officers or agents shall not be responsible for the accuracy or completeness of electronic copies of this plan sheet.

To accompany plans dated April 11 1998

- H8 Planting and Irrigation- Details

TEMPORARY FACILITIES

- T1 Temporary Crash Cushion, Sand Filled
- T2 Temporary Crash Cushion, Sand Filled
- T3 Temporary Railing (Type K)
- T4 Temporary Traffic Screen
- T5 Temporary Terminal Section (Type K)
- T7 Construction Project Funding Identification Signs
- T10 Traffic Control System for Lane Closure on Freeways and Expressways
- T10A Traffic Control System for Lane and Complete Closures on Freeways and Expressways
- T11 Traffic Control System for Lane Closure on Multilane Conventional Highways
- T12 Traffic Control System for Lane Closure on Multilane Conventional Highways
- T13 Traffic Control System for Lane Closure on Two Lane Conventional Highways
- T14 Traffic Control System for Ramp Closures
- T15 Traffic Control System for Moving Lane Closure on Multilane Highways
- T16 Traffic Control System for Moving Lane Closure on Multilane Highways
- T17 Traffic Control System for Moving Lane Closure on Two Lane Highways

BRIDGE

- B0-1 Bridge Details
- B0-3 Bridge Details
- B0-5 Bridge Details
- B0-13 Bridge Details
- B2-3 400 mm Cast-In-Drilled-Hole Concrete Pile
- B2-5 Pile Details- Class 400 and Class 625
- B2-6 Pile Details- Class 400C and Class 625C
- B2-8 Pile Details- Class 900 and Class 900C
- B2-9 Load Test Pile Details (1)
- B2-10 Load Test Pile Details (2)
- B2-11 Load Test Pile Details (3)
- RSP B3-1 RETAINING WALL TYPE 1- H=1200 THROUGH 9100 mm
- B3-2 Retaining Wall Type 1- H=9700 Through 10 900 mm
- RSP B3-3 RETAINING WALL- TYPE 1A
- B3-4 Retaining Wall- Type 2
- B3-5 Counterfort Retaining Wall- Type 3
- B3-6 Counterfort Retaining Wall- Type 4
- RSP B3-7 RETAINING WALL- TYPE 5
- RSP B3-8 RETAINING WALL DETAILS No. 1
- B3-9 Retaining Wall Details No. 2
- B3-11 Retaining Wall Type 6- 1829 mm Maximum
- B6-1 T-Beam Details
- B6-10 Utility Openings, T-Beam
- B6-21 Joint Seals (Maximum Movement Rating = 50 mm)
- B7-1 Box Girder Details
- B7-5 Deck Drains
- B7-6 Deck Drains- Type D-1 and D-2
- B7-10 Utility Opening- Box Girder
- B7-11 Utility Details
- B8-5 Cast-In-Place Prestressed Girder Details
- B11-7 Chain Link Railing
- B11-47 Cable Railing
- B11-51 Tubular Hand Railing
- B11-52 Chain Link Railing Type 7
- B11-53 Concrete Barrier Type 25
- B11-54 Concrete Barrier Type 26

AS - BUILT

SHEET 1 OF 2

STANDARD PLANS LIST

(July,1997 Edition)

REVISED DECEMBER 4, 1997

WEB SITE ADDRESS: <http://www.dot.ca.gov/hq/esc/projplan/ppintro.htm>

- ☐ B13-1

Slope Protection Details
- ☐ B14-1

Structural Steel Plate Vehicular Undercrossing
- ☐ B14-3

Communication and Sprinkler Control Conduit (Conduit less than size 103)
- ☐ B14-4

Water Supply Line (Bridge) (Pipe less than NPS 4)
- ☐ B14-5

Water Supply Line (Details) (Pipe less than NPS 4)

ROADSIDE SIGNS

- ☒ RS1

Roadside Signs, Typical Installation Details No. 1
- ☒ RS2

Roadside Signs, Wood Post, Typical Installation Details No. 2
- ☐ RS3

Roadside Signs, Laminated Wood Box Post, Typical Installation Details No. 3
- ☐ RS4

Roadside Signs, Typical Installation Details No. 4

OVERHEAD SIGNS

OVERHEAD SIGNS-TRUSS

- ☐ S1

Overhead Signs- Truss, Instructions and Examples
- ☐ S2

Overhead Signs- Truss, Single Post Type, Post Types 11 thru V11
- ☐ S3

Overhead Signs- Truss, Two Post Type, Post Types 1-S thru V11-S
- ☐ RSP S4

OVERHEAD SIGNS- TRUSS, SINGLE POST TYPE, STRUCTURAL FRAME MEMBERS
- ☐ S5

Overhead Signs- Truss, Two Post Type, Structural Frame Members
- ☐ S6

Overhead Signs- Truss, Structural Frame Details
- ☐ S7

Overhead Signs- Truss, Frame Juncture Details
- ☐ S8A

Overhead Signs- Steel Frame Removable Sign Panel Frames
- ☐ S8B

Overhead Signs- Removable Sign Panel Frames, Overhead Formed Panel Mounting Details
- ☐ S8C

Overhead Signs- Truss, Sign Panel Mounting Details, Laminated Panel- Type A
- ☐ S8D

Overhead Signs- Truss, Removable Sign Panel Frames 2.794 m and 3.048 m Sign Panels
- ☐ S9

Overhead Signs- Walkway Details No. 1
- ☐ S10

Overhead Signs- Walkway Details No. 2
- ☐ S11

Overhead Signs- Walkway Safety Railing Details
- ☐ S13

Overhead Signs- Truss Pile Foundation

OVERHEAD SIGNS-LIGHTWEIGHT

- ☐ S14A

Overhead Signs- Lightweight Balanced-Single Steel Post Connection and Mounting Details
- ☐ S14B

Overhead Signs- Lightweight Balanced-Single Steel Post Details
- ☐ S15

Overhead Signs- Lightweight, Type A, Connection Details
- ☐ S16

Overhead Signs- Lightweight, Type B, Connection Details
- ☐ S17

Overhead Signs- Lightweight, Type C, Connection Details
- ☐ S18A

Overhead Signs- Lightweight, Sign Panel Mounting Details, Laminated Panel- Type A
- ☐ S18B

Overhead Signs- Lightweight, Light Fixture Mounting Details
- ☐ S20A

Overhead Signs- Lightweight Post Details
- ☐ S20B

Overhead Signs- Lightweight Foundation Details

OVERHEAD SIGNS-BOX BEAM CLOSED TRUSS ALTERNATIVE

- ☐ S39

Overhead Signs- Box Beam Closed Truss, Foundation Details
- ☐ S40A

Overhead Signs- Box Beam Closed Truss, Two Post Type Frame Members
- ☐ S40B

Overhead Signs- Box Beam Closed Truss, Single and Two Post Type, General Frame Details
- ☐ S40C

Overhead Signs- Box Beam Closed Truss, Ribbed Sheet Metal Details
- ☐ S40D

Overhead Signs- Box Beam Closed Truss, Two Post Type, Frame Details
- ☐ S40E

Overhead Signs- Box Beam Closed Truss, Two Post Type, Frame Juncture Details
- ☐ S40F

Overhead Signs- Box Beam Closed Truss, Two Post Type, Post Details
- ☐ S40G

Overhead Signs- Box Beam Closed Truss, Single Post Type, Frame Members
- ☐ S40H

Overhead Signs- Box Beam Closed Truss, Single Post Cantilever, Frame Details
- ☐ S40I

Overhead Signs- Box Beam Closed Truss, Single Post Cantilever, Frame Juncture Details
- ☐ S40J

Overhead Signs- Box Beam Closed Truss, Single Post Cantilever, Post Details
- ☐ S40K

Overhead Signs- Box Beam Closed Truss, Single Post Butterfly, Frame Details
- ☐ S40L

Overhead Signs- Box Beam Closed Truss, Single Post Butterfly, Frame Juncture Details

- ☐ S40M

Overhead Signs- Box Beam Closed Truss, Single Post Butterfly, Post Details

OVERHEAD SIGNS-TUBULAR

- ☐ S40N

Overhead Signs- Tubular, Instructions and Examples
- ☐ S40P

Overhead Signs- Tubular, Single Post Type, Layout and Pipe Selection
- ☐ S40Q

Overhead Signs- Tubular, Two Post Type, Layout and Pipe Selection
- ☐ S40R

Overhead Signs- Tubular, Structural Frame Details No. 1
- ☐ S40S

Overhead Signs- Tubular, Structural Frame Details No. 2
- ☐ S40T

Overhead Signs- Tubular, Foundation Details

SIGNALS, LIGHTING AND ELECTRICAL SYSTEMS

- ☒ ES-1A

Signal, Lighting and Electrical Systems- Symbols and Abbreviations
- ☒ ES-1B

Signal, Lighting and Electrical Systems- Symbols and Abbreviations
- ☒ ES-2A

Signal, Lighting and Electrical Systems- Service Equipment
- ☒ ES-2B

Signal, Lighting and Electrical Systems- Service Equipment
- ☒ ES-2C

Signal, Lighting and Electrical Systems- Service Equipment Notes
- ☒ ES-2D

Signal, Lighting and Electrical Systems- Service Equipment and Typical Wiring Diagram, Type A
- ☐ ES-2E

Signal, Lighting and Electrical Systems- Service Equipment and Typical Wiring Diagram, Type B
- ☐ ES-2F

Signal, Lighting and Electrical Systems- Service Equipment and Typical Wiring Diagram, Type C
- ☐ ES-3A

Signal, Lighting and Electrical Systems- Signal Heads and Mountings
- ☐ ES-3B

Signal, Lighting and Electrical Systems- Signal Heads and Mountings
- ☐ ES-3C

Signal, Lighting and Electrical Systems- Signal Heads and Mountings
- ☐ ES-3D

Signal, Lighting and Electrical Systems- Signal Heads and Mountings
- ☐ ES-3E

Signal, Lighting and Electrical Systems- Signal Heads and Mountings
- ☐ ES-4A

Signal, Lighting and Electrical Systems- Controller Cabinet Details
- ☐ ES-4B

Signal, Lighting and Electrical Systems- Controller Cabinet Details
- ☐ ES-4C

Signal, Lighting and Electrical Systems- Controller Cabinet Details
- ☐ ES-4D

Irrigation Controller Enclosure Cabinet
- ☐ ES-5A

Signal, Lighting and Electrical Systems- Detectors
- ☐ ES-5B

Signal, Lighting and Electrical Systems- Detectors
- ☐ ES-5C

Signal, Lighting and Electrical Systems- Detectors
- ☐ ES-5D

Signal, Lighting and Electrical Systems- Detectors
- ☐ ES-5E

Signal, Lighting and Electrical Systems- Detectors
- ☐ ES-5F

Signal, Lighting and Electrical Systems- Pedestrian Barricades
- ☐ ES-6A

Signal and Lighting Standards- Type 1 Standards and Equipment Numbering
- ☐ ES-6AA

Signal Standards- Push Button Posts
- ☐ ES-6B

Lighting Standards- Types 15, 21 and 22
- ☐ ES-6C

Lighting Standards- 24.4 m to 48.8 m High Mast Light Pole, Foundation Details
- ☐ ES-6D

Lighting Standards- Types 30 and 31
- ☐ ES-6DA

Lighting Standards- Type 32
- ☐ ES-6E

Lighting Standards- Types 30 and 31, Base Details
- ☐ ES-6F

Lighting Standards- 10 Degree Type
- ☐ ES-6H

Lighting Standards- 10 Degree Type, Details
- ☐ RSP ES-6J

SIGNAL AND LIGHTING STANDARDS- CASE 1 ARM LOADING, WIND VELOCITY = 113 km/h, ARM LENGTHS 4.6 m TO 9.1 m
- ☐ ES-6K

Signal and Lighting Standards- Case 2 Arm Loading, Wind Velocity = 113 km/h, Arm Lengths 6.1 m to 9.1 m
- ☐ ES-6L

Signal and Lighting Standards- Case 3 Arm Loading, Wind Velocity = 113 km/h, Arm Lengths 4.6 m to 13.7 m
- ☐ ES-6M

Signal and Lighting Standards- Case 4 Arm Loading, Wind Velocity = 113 km/h, Arm Lengths 7.6 m to 13.7 m
- ☐ ES-6MA

Signal and Lighting Standards- Case 5 Arm Loading, Wind Velocity = 113 km/h, Arm Lengths 15.2 m to 16.8 m
- ☐ ES-6N

Signal and Lighting Standards- Type 40-0-129
- ☐ ES-6O

Signal and Lighting Standards- Case 1 Arm Loading, Wind Velocity = 129 km/h, Arm Lengths 7.6 m to 9.1 m
- ☐ ES-6P

Signal and Lighting Standards- Case 2 Arm Loading, Wind Velocity = 129 km/h, Arm Lengths 6.1 m to 9.1 m
- ☐ ES-6Q

Signal and Lighting Standards- Case 3 Arm Loading, Wind Velocity = 129 km/h, Arm Lengths 6.1 m to 13.7 m



DIST.	COUNTY	ROUTE	KILOMETER POST TOTAL PROJECT	SHEET NO.	TOTAL SHEETS
7	LA	1,5,91,164 210,605	VAR	5	61
The State of California or its officers or agents shall not be responsible for the accuracy or completeness of electronic copies of this plan sheet.					

To accompany plans dated April 1998

- ☐ RSP ES-6R

SIGNAL AND LIGHTING STANDARDS- CASE 4 ARM LOADING, WIND VELOCITY = 129 km/h, ARM LENGTHS 7.6 m TO 13.7 m
- ☐ ES-6RA

Signal and Lighting Standards- Case 5 Arm Loading, Wind Velocity = 129 km/h, Arm Lengths 15.2 m to 16.8 m
- ☐ ES-6RB

Signal and Lighting Standards- Case 5 Arm Loading, Wind Velocity = 129 km/h, Arm Lengths 18.2 m to 19.8 m
- ☐ ES-6S

Signal and Lighting Standards- Details No. 1
- ☐ ES-6T

Signal and Lighting Standards- Details No. 2
- ☐ ES-6TA

Signal and Lighting Standards- Pole and Mast Arm Alternatives
- ☐ ES-6U

Lighting Standards- Type 15 Slip Base Insert
- ☐ ES-6V

Signal and Sign Standards- Type 33 Left Turn
- ☐ ES-7A

Signal, Lighting and Electrical Systems- Electrical Details, Structure Installations
- ☐ ES-7B

Signal, Lighting and Electrical Systems- Electrical Details, Structure Installations
- ☐ ES-7C

Signal, Lighting and Electrical Systems- Electrical Details, Structure Installations
- ☐ ES-7D

Signal, Lighting and Electrical Systems- Electrical Details, Structure Installations
- ☐ ES-7E

Signal, Lighting and Electrical Systems- Electrical Details, Structure Installations
- ☐ ES-7F

Signal, Lighting and Electrical Systems- Flush Soffit Luminaire Modification Details, Structure Installations
- ☒ ES-8

Signal, Lighting and Electrical Systems- Pull Box Details
- ☐ ES-9A

Signal, Lighting and Electrical Systems- Cantilever Flashing Beacon, Types 9, 9A and 9B
- ☐ ES-9B

Signal, Lighting and Electrical Systems- Cantilever Flashing Beacon, Types 9, 9A and 9B
- ☐ ES-10

Signal, Lighting and Electrical Systems- Isolux Diagrams
- ☐ ES-11

Signal, Lighting and Electrical Systems- Foundation Installations
- ☐ ES-12

Signal, Lighting and Electrical Systems- Pedestrian Undercrossing Fluorescent Lighting Fixture
- ☐ ES-13

Signal, Lighting and Electrical Systems- Splicing Details
- ☐ ES-14

Signal, Lighting and Electrical Systems- Wiring Details and Fuse Ratings
- ☐ ES-15

Signal, Lighting and Electrical Systems- Pedestrian Overcrossing Fluorescent Lighting Fixture
- ☐ ES-27A

Signal, Lighting and Electrical Systems- Extinguishable Message Sign, 250 mm Letters
- ☐ ES-27B

Signal, Lighting and Electrical Systems- Extinguishable Message Sign, 250 mm Letters
- ☐ ES-28

Signal, Lighting and Electrical Systems- Extinguishable Message Sign and Flashing Beacons

SIGN ILLUMINATION

- ☐ ES-29

Sign Illumination- Mercury Sign Illumination Equipment
- ☐ ES-30

Sign Illumination- 915 mm Fluorescent Sign Illumination Equipment
- ☐ ES-32A

Sign Illumination- Sign Illumination Equipment
- ☐ ES-32B

Sign Illumination- Sign Illumination Control
- ☐ ES-33

Sign Illumination- Internally Illuminated Street Name Sign

CLOSED CIRCUIT TELEVISION

- ☐ RSP ES-34A

CLOSED CIRCUIT TELEVISION- POLE DETAILS
- ☐ ES-34B

Closed Circuit Television- Pole Details- Overhead Sign Mounted

NEW STANDARD PLANS

- ☐ NSP D75APIPE

INLETS
- ☐ NSP D75BPIPE

INLETS
- ☐ NSP D75CPIPE

INLETS- LADDER, STEP AND TRASH RACK DETAILS

AS - BUILT

SHEET 2 OF 2
STANDARD PLANS LIST

(July,1997 Edition)
REVISED DECEMBER 4, 1997


WEB SITE ADDRESS: <https://www.dot.ca.gov/hq/esc/projplan/ppintro.htm>

The Standard Plan sheets applicable to this contract include, but are not limited to those indicated by a marked box.

USERNAME =C\$USER

CONTRACT NO.

DATE PLOTTED =C 22-MAY-2000
TIME PLOTTED =C 09:28

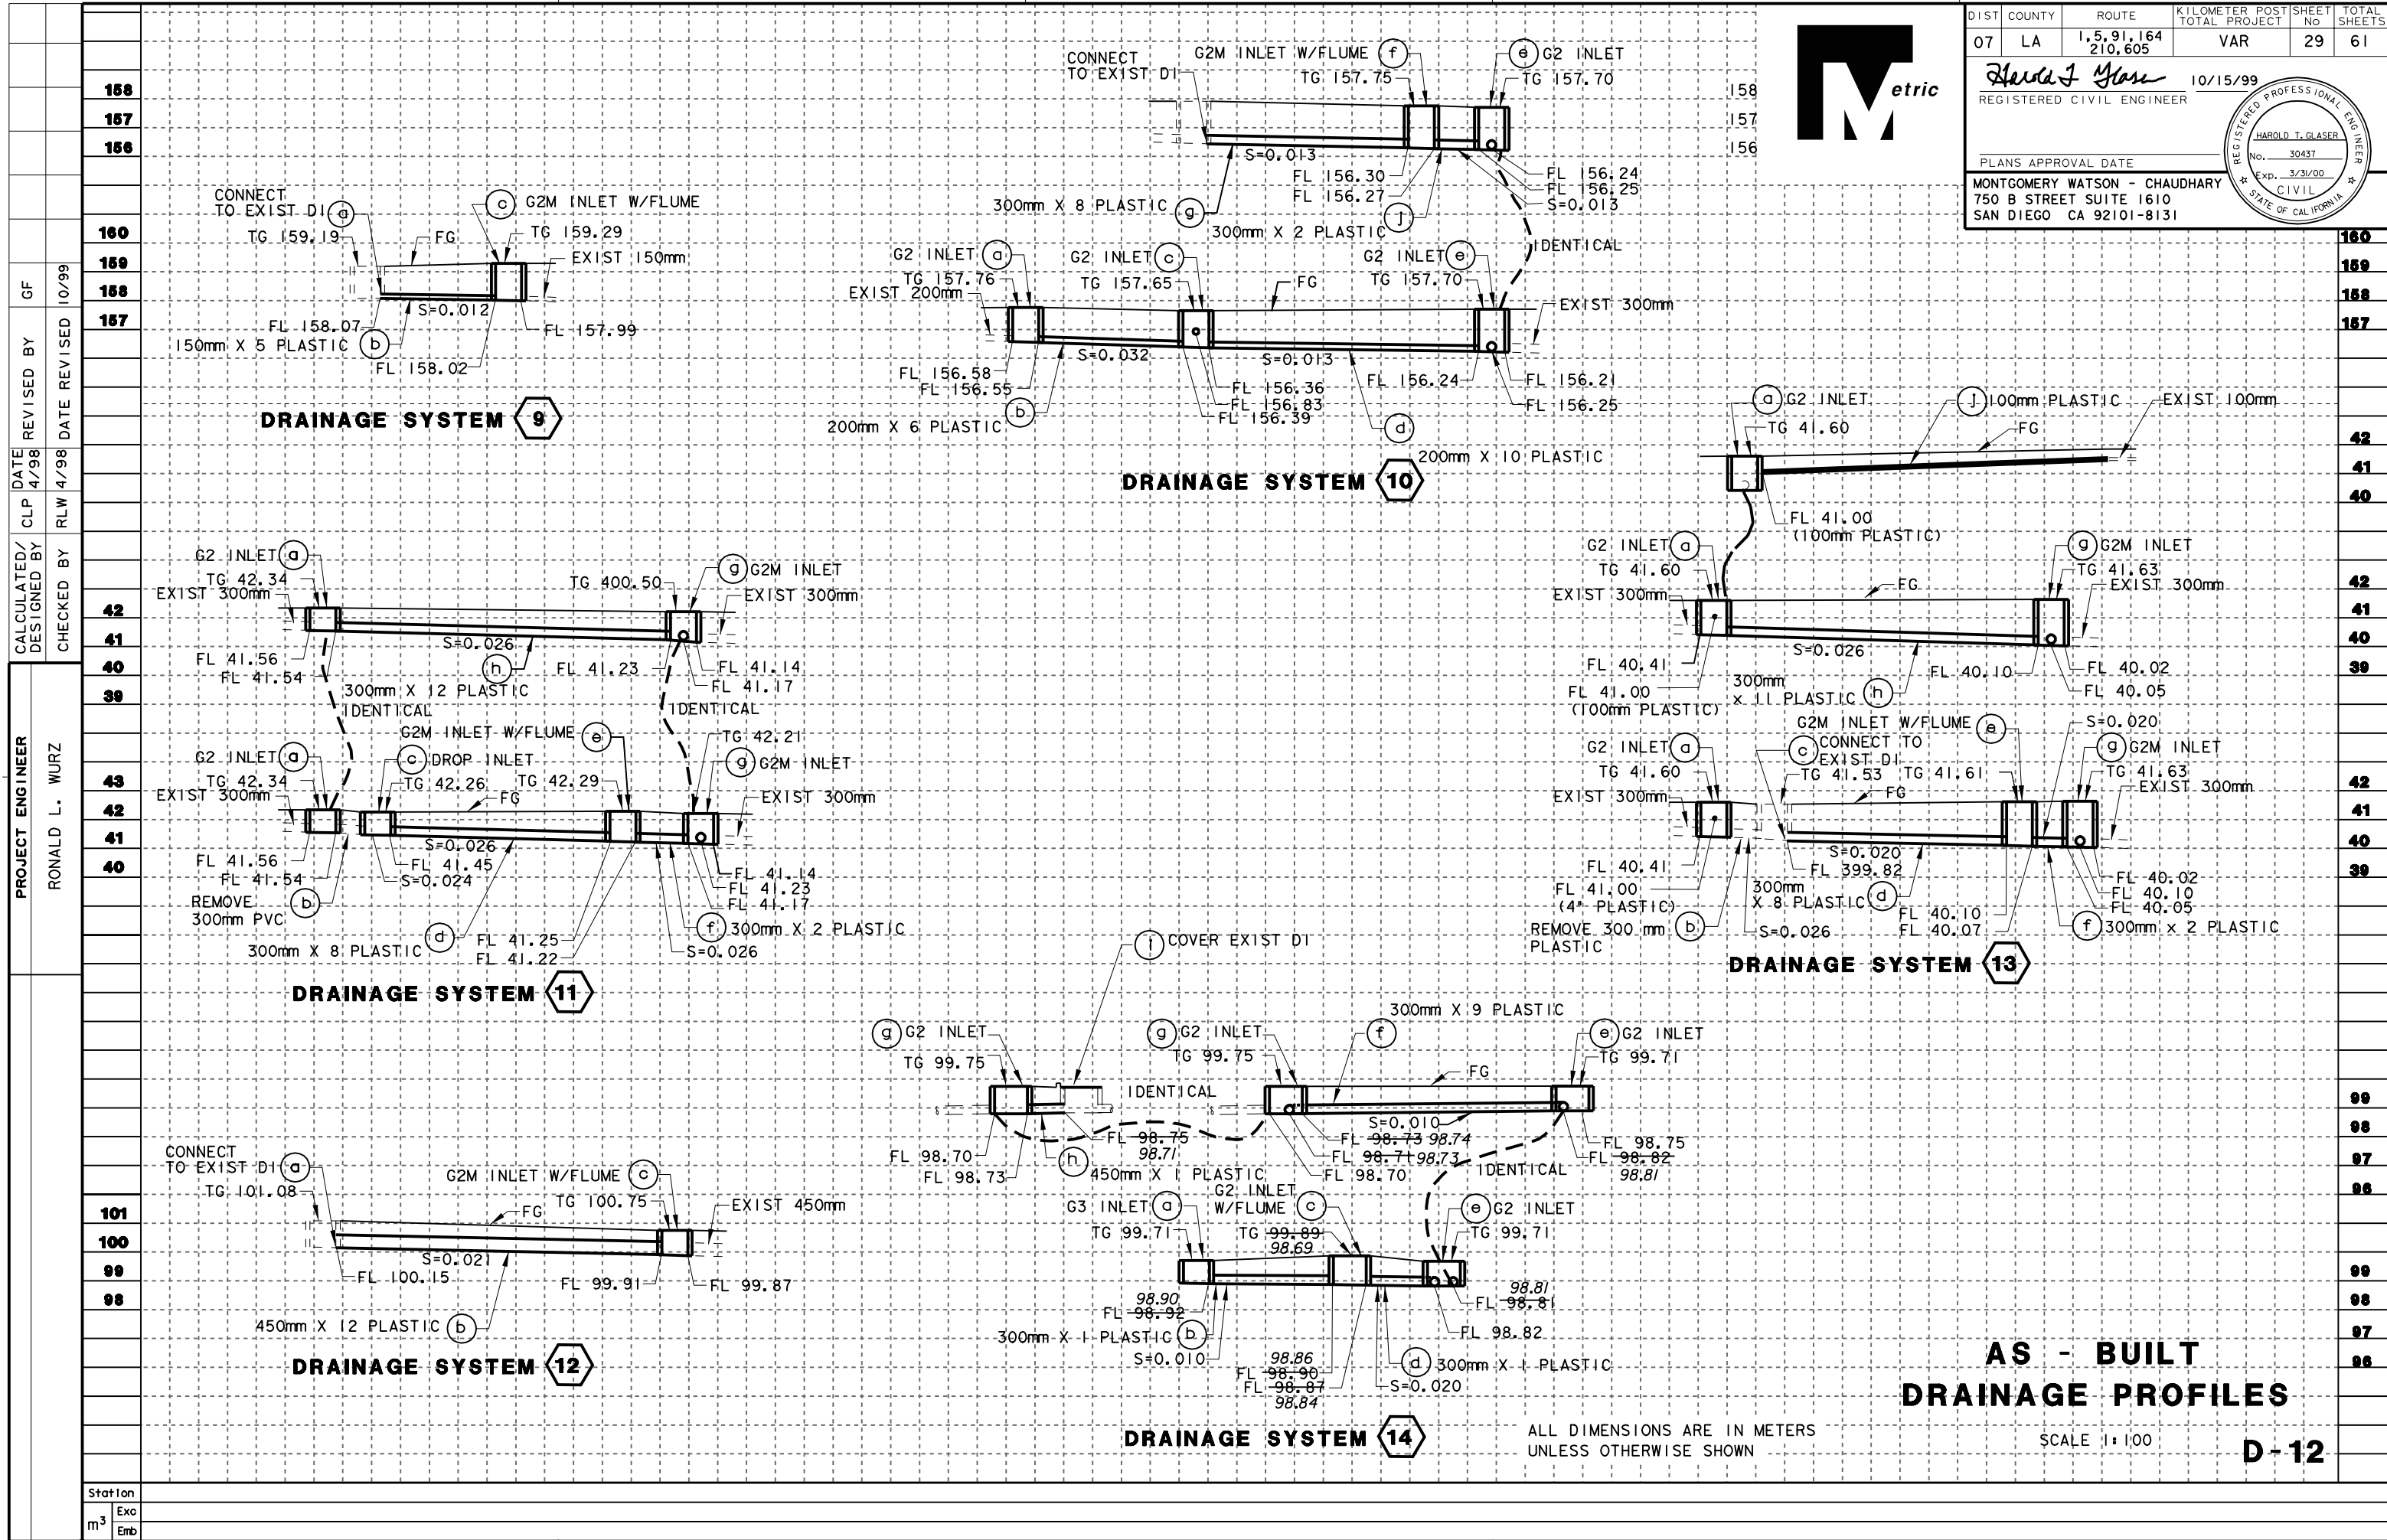

DIST	COUNTY	ROUTE	KILOMETER TOTAL	POST PROJECT	SHEET NO	TOTAL SHEETS
07	LA	1,5,91,164 210,605	VAR	10/15/99	29	61

REGISTERED CIVIL ENGINEER
HAROLD T. GLASER
No. 30437
Exp. 3/31/00
CIVIL
STATE OF CALIFORNIA

PLANS APPROVAL DATE
MONTGOMERY WATSON - CHAUDHARY
750 B STREET SUITE 1610
SAN DIEGO CA 92101-8131

**AS - BUILT
DRAINAGE PROFILES**
SCALE 1:100
D-12

ALL DIMENSIONS ARE IN METERS
UNLESS OTHERWISE SHOWN




PROJECT ENGINEER
RONALD L. WURZ

CALCULATED/ DESIGNED BY
CLP 4/98


CHECKED BY
RLW 4/98

DATE REVISED
10/99


GF

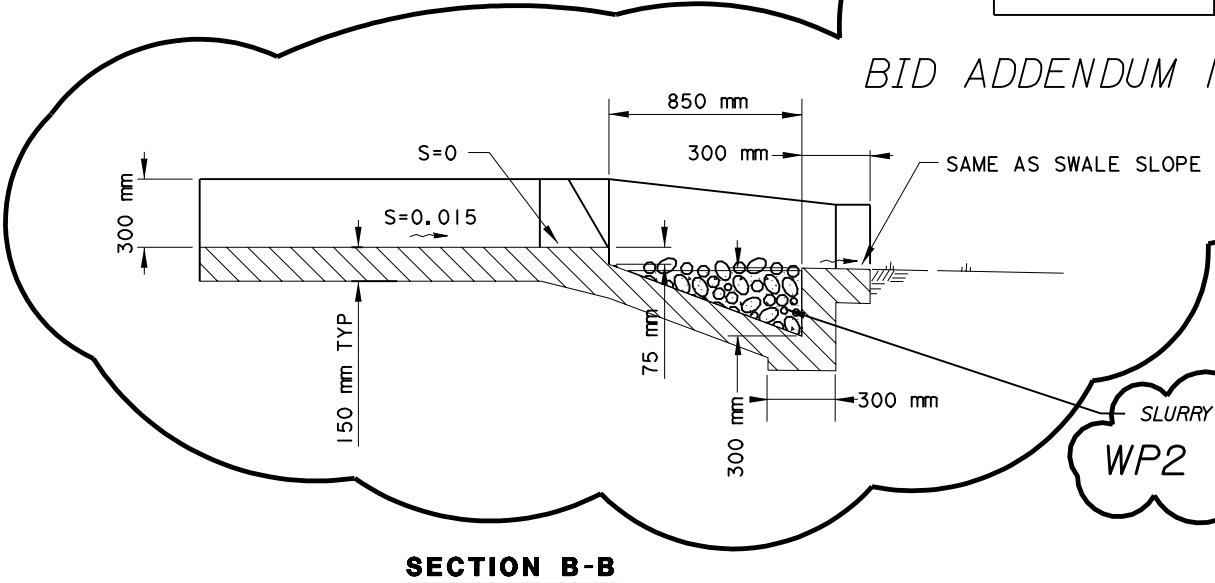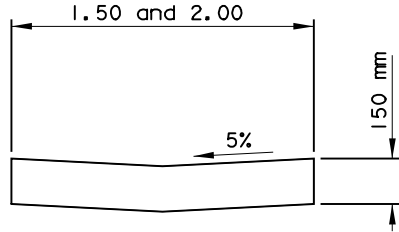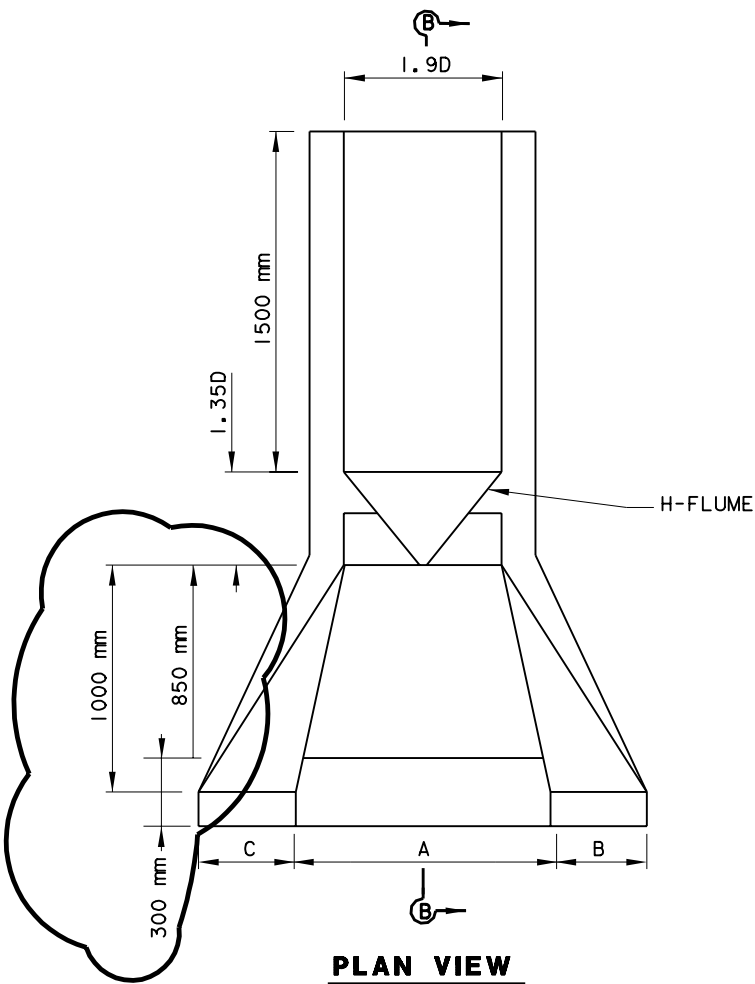


DRAIN. UNIT NO.	A	B	C	D
2c	1.5	1.2	1.2	0.229
6b	1.5	0.5	0.5	0.305
7e	2.0	0.6	0.6	0.305
8b	1.0	0.6	0.6	0.305

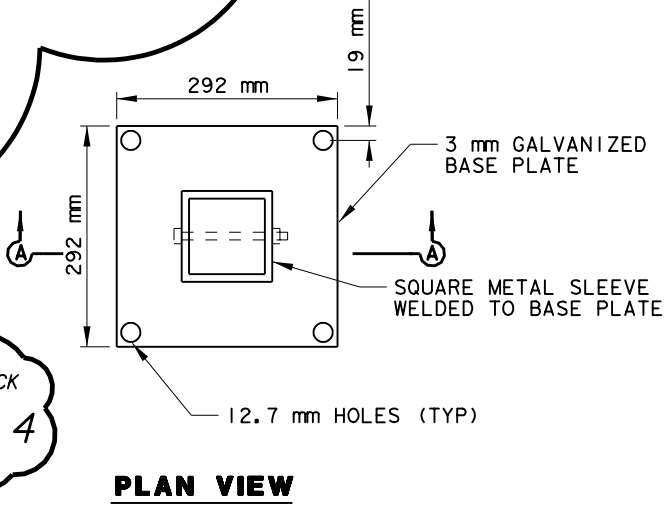

H - FLUME TO SWALE TRANSITION

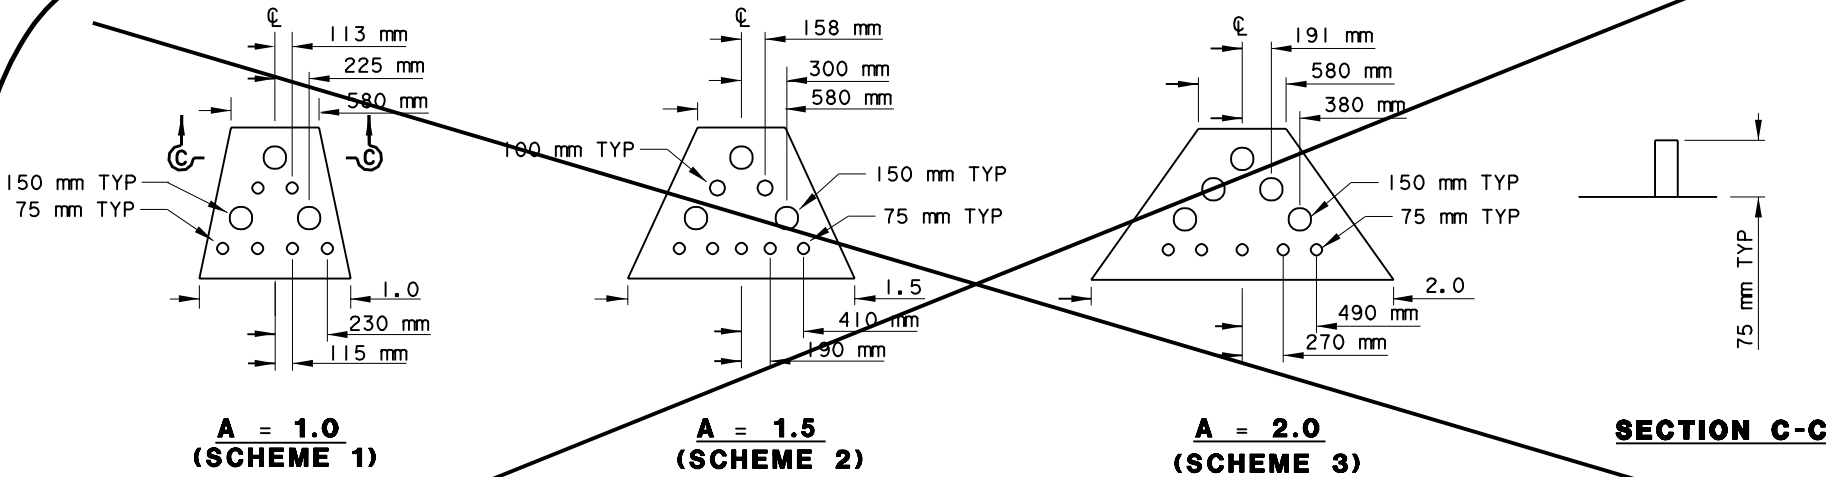

SECTION C-C

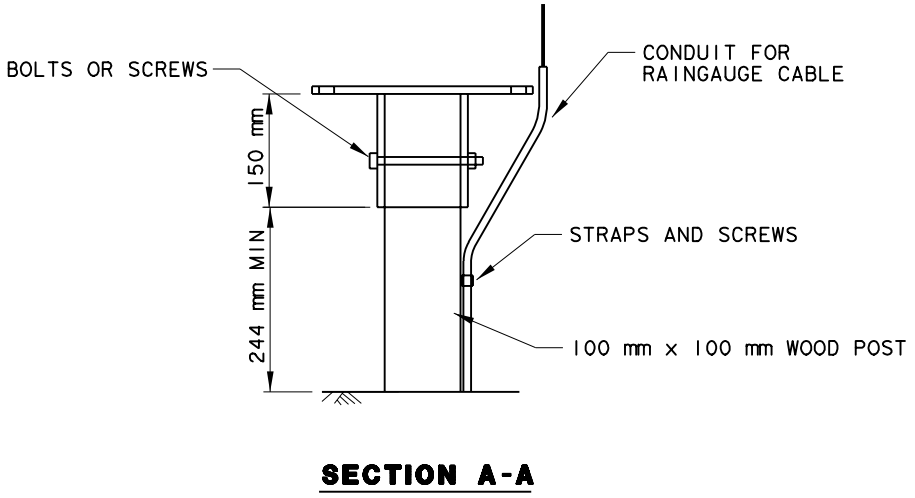

RAIN GAUGE MOUNTING PLATFORM

AS - BUILT DRAINAGE DETAILS

ALL DIMENSIONS ARE IN METERS UNLESS OTHERWISE SHOWN

NO SCALE

PROJECT ENGINEER

RONALD L. WURZ

CALCULATED/DESIGNED BY

GF

DATE

4/98

PNX


4/98

CHECKED BY


RLW

DATE REVISED


10/99

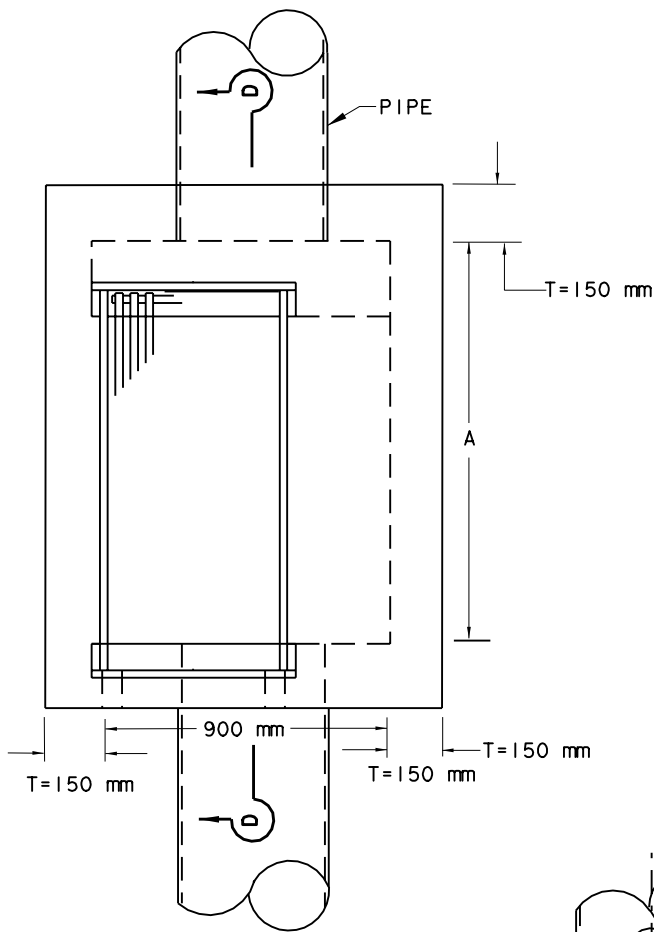


G2M INLET

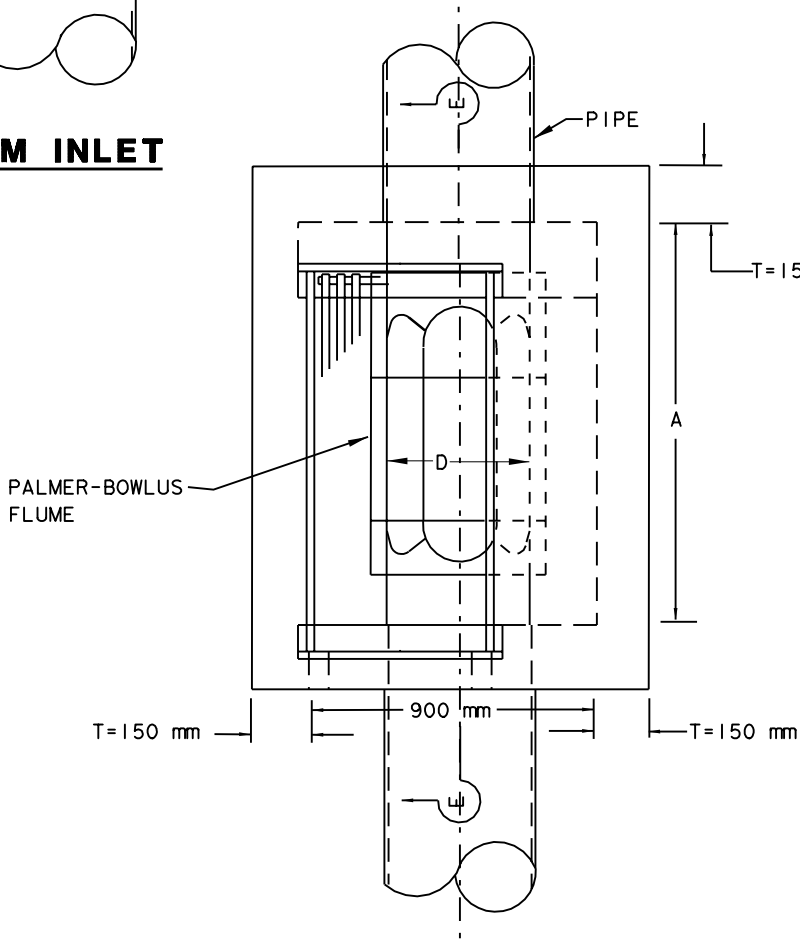

G2M INLET W/ FLUME

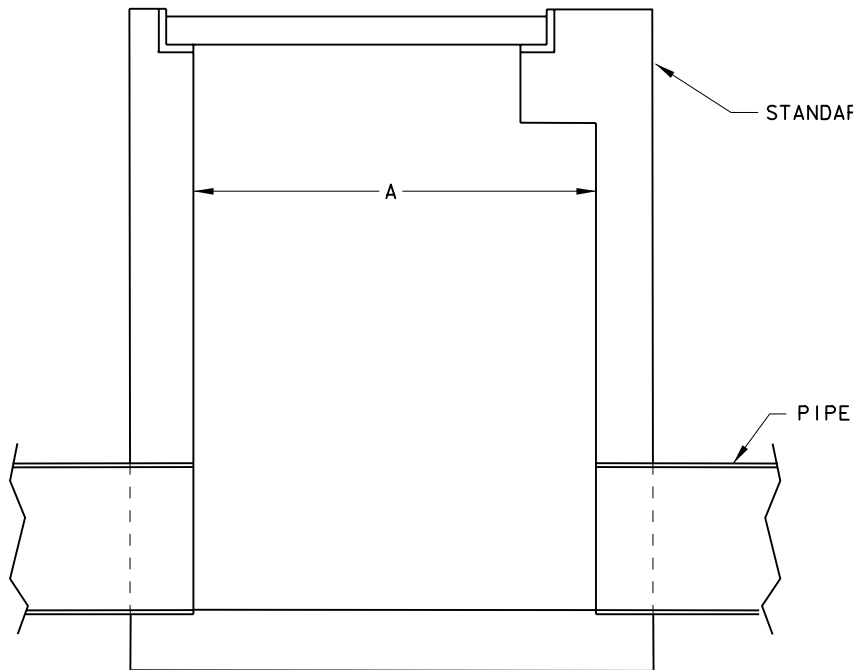

SECTION D-D

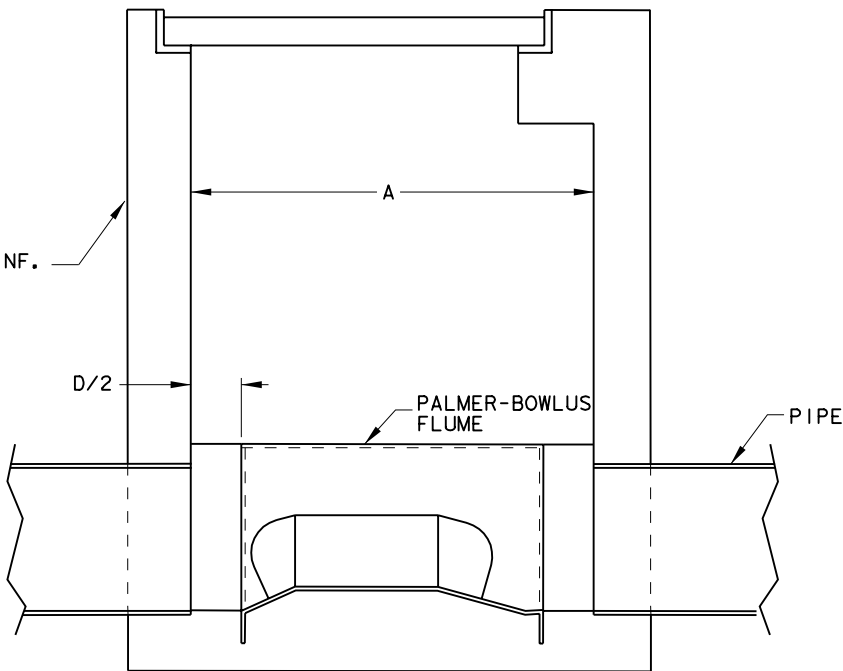

SECTION E-E

BOX DIMENSIONS			
DRAINAGE UNIT NO.	A	FLUME	D
9c	1.40	x	0.203
10e	2.30		
10f	1.40	x	0.457
11e	1.40	x	0.203
11g	2.30		
12c	1.40	x	0.381
13e	1.40	x	0.305
13g	2.30		
14c	1.40	x	0.254
14e	2.30		



DIST

COUNTY

ROUTE

KILOMETER POST TOTAL PROJECT

SHEET NO

TOTAL SHEETS

07

LA

1,5,91,164
210,605

VAR

34

61

Harold T. Glaser

10/15/99

REGISTERED CIVIL ENGINEER

PLANS APPROVAL DATE

MONTGOMERY WATSON - CHAUDHARY

750 B STREET SUITE 1610

SAN DIEGO CA 92101-8131

REGISTERED PROFESSIONAL ENGINEER


HAROLD T. GLASER

No. 30437

Exp. 3/31/00

CIVIL

STATE OF CALIFORNIA

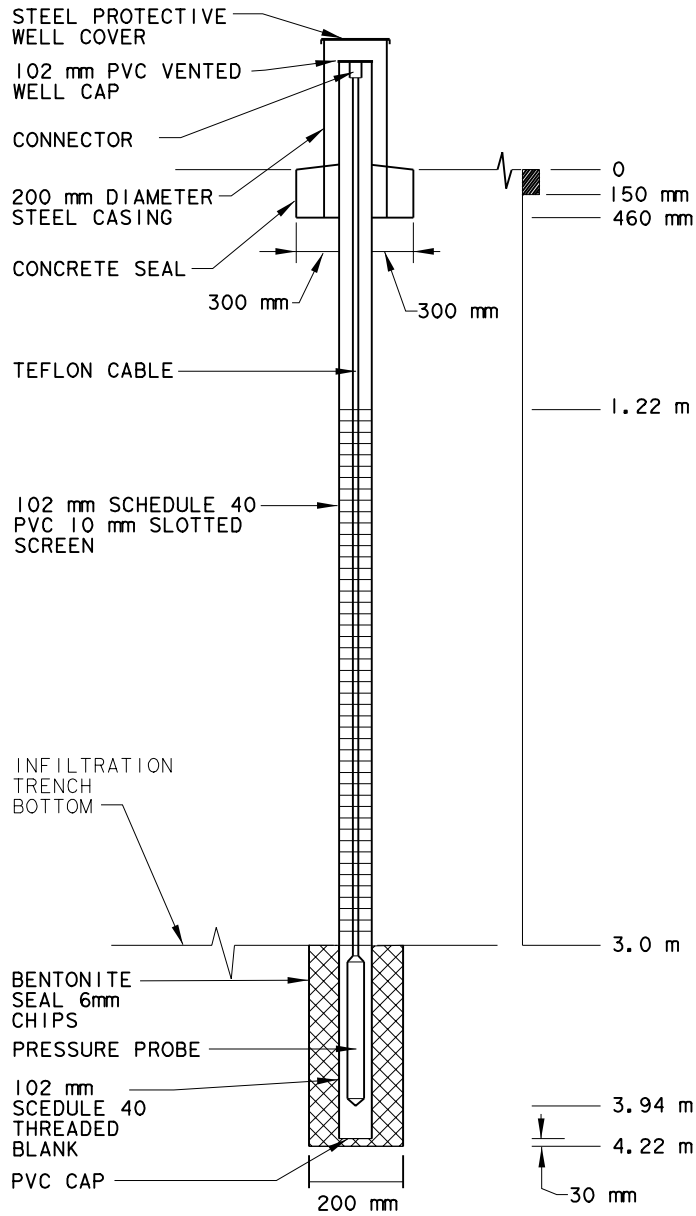

MONITORING WELL

AS - BUILT
DRAINAGE DETAILS

NO SCALE

ALL DIMENSIONS ARE IN
METERS UNLESS OTHERWISE SHOWN

[illegible]

DRAINAGE QUANTITIES

NO SCALE

D - 23

x

x

PROJECT ENGINEER

RONALD L. WURZ

CALCULATED/
DESIGNED BY

CHECKED BY

DATE
CLP 4/98

RLW 4/98

GF

DATE REVISED
10/99

PLACE ASPHALT CONCRETE DIKE

LOCATION	TYPE E m	TYPE C m
S 5/605 INTERCHANGE	110 0	-
N 605/CARSON & DEL AMO INTERCHANGE	58 57	57
N 605/91 INTERCHANGE	40 39	-
TOTAL	208 96	57

CHAIN LINK FENCE

LOCATION	CL-1.8 M
ALTADENA MAINTENANCE STATION	61 67
TOTAL	61 67

MINOR CONCRETE
(MINOR STRUCTURE)

LOCATION	m ³
ALTADENA MAINTENANCE STATION	3.19 28.7
N 605/91 INTERCHANGE	1.3
W 91/CERRITOS MAINTENANCE STATION	0.6
S 5/605 INTERCHANGE	0.6
N 605/CARSON & DEL AMO INTERCHANGE	0.6
FOOTHILL MAINTENANCE STATION	5.7
LAS FLORES MAINTENANCE STATION	5.4
ROSEMEAD MAINTENANCE STATION	3.5
TOTAL	6.29 46.4

1.5 M CHAIN LINK GATE

LOCATION	TYPE CL-1.8 EA m
ALTADENA MAINTENANCE STATION	2 3
TOTAL	2 3

3 M CHAIN LINK GATE

LOCATION	TYPE CL-1.8 EA
W 91/CERRITOS MAINTENANCE STATION	1
TOTAL	1



DIST	COUNTY	ROUTE	KILOMETER POST TOTAL PROJECT	SHEET NO	TOTAL SHEETS
07	LA	1,5,91,164 210,605	VAR	47	61
<i>Harold T. Glaser</i>		10/15/99			
REGISTERED CIVIL ENGINEER					
PLANS APPROVAL DATE					
MONTGOMERY WATSON - CHAUDHARY 750 B STREET SUITE 1610 SAN DIEGO CA 92101-8131					

REGISTERED PROFESSIONAL ENGINEER

HAROLD T. GLASER

No. 30437

EXP. 3/31/00

CIVIL

STATE OF CALIFORNIA

REMOVE AC DIKE

LOCATION	m
S 5/605 INTERCHANGE	110 0
N 605/CARSON & DEL AMO INTERCHANGE	115 114
N 605/91 INTERCHANGE	98
TOTAL	323 212

AS-BUILT

SUMMARY OF QUANTITIES

ALL DIMENSIONS ARE IN
METERS UNLESS OTHERWISE SHOWN

NO SCALE

Q-1

PROJECT ENGINEER

RONALD L. WURZ

CALCULATED/DESIGNED BY

CLP

DATE

4/98

REVIS

GF

DATE

10/99

CHECKED BY

RLW

DATE

4/98



DIST	COUNTY	ROUTE	KILOMETER TOTAL PROJECT	POST NO	SHEET NO	TOTAL SHEETS
07	LA	1,5,91,164 210,605	VAR		49	61
Harold J. Glaser		10/15/99				
REGISTERED CIVIL ENGINEER						
PLANS APPROVAL DATE						
MONTGOMERY WATSON - CHAUDHARY 750 B STREET SUITE 1610 SAN DIEGO CA 92101-8131						

REGISTERED PROFESSIONAL ENGINEER

HAROLD T. GLASER

No. 30437

EXP. 3/31/00

CIVIL

STATE OF CALIFORNIA

RETAINING WALL QUANTITIES

WALL	STATION LIMITS	STRUCTURAL CONCRETE, RETAINING WALL (m3)	BAR REINF STEEL (RW) (kg)	PERVIOUS BACKFILL MATERIAL * (m3)	NONWOVEN FILTER FABRIC (m3)
"RW102"	102+5.40 - 102+33.36	22	1100	5	82
TOTAL		22	1100	5	82

CABLE RAILING

WALL	STATION LIMITS	m
"RW102"	102+5.40 - 102+33.36	28
TOTAL		28

BID ADD.1

INFILTRATION TRENCH

LOCATION	GRADED AND WASHED GRAVEL (m3)	FILTER FABRIC (m2)	SHEET PILING (m2)
ALTADENA MAINTENANCE STATION	480 607	542 515	171 170
TOTAL			

METAL BEAM GUARD RAILING

LOCATION	CABLE ANCHOR ASSEMBLY			TERMINAL SYSTEM		MBGR
	BREAKAWAY					
	TYPE B				TYPE SRT	
	EA				EA	m
N 605/CARSON & DEL AMO SEPARATION	1				1	69
TOTAL						

STORAGE BAYS

LOCATION	STRUCTURAL CONCRETE (m3)	BAR REINF STEEL (kg)	REMOVE EXISTING BAY EA
ALTADENA MAINTENANCE STATION	20 49	600 3529	3 6
TOTAL			

MONITORING

LOCATION	MONITORING WELL EA	LYSIMETER EA		RAIN GAUGE PLATFORM EA
ALTADENA MAINTENANCE STATION	1	1		
FOOTHILL MAINTENANCE STATION				1
LAS FLORES MAINTENANCE STATION				1
ROSEMEAD MAINTENANCE STATION				1
TOTAL				

LANDSCAPING

LOCATION	EROSION CONTROL SEED (ha)	BMP SEED (ha)	TOPSOIL (m3)	REMOVE EXIST TREE EA
ALTADENA MAINTENANCE STATION		0.016 0.015	96 107	
N 605/91 SEPARATION	0.321	0.068 0.054	324 132	
W 91 BEHIND CERRITOS MAINTENANCE STATION	0.011	0.005 0.003	18	
S 5/605 SEPARATION	0.122	0.015 0.008	21 48	1
N 605/CARSON & DEL AMO SEPARATION	0.040	0.011 0.005	21 32	1
TOTAL				

AS-BUILT

SUMMARY OF QUANTITIES

NO SCALE

ALL DIMENSIONS ARE IN METERS UNLESS OTHERWISE SHOWN

